

DEEPSEA ATLANTIC

MARITIME INFO:

TLF. BRIDGE: +47 52886200
DSA WORK Channel: VHF Channel 72
Statoil Field Channel: VHF Channel 14

E-mail BRIDGE:
 dsa-dpop@odfjelldrilling.com

E-mail OIM:
 dsa-offinst@odfjelldrilling.com

UHF CHANNELS DSA:

STATOIL CH152 DSA CH 2
 TX: 408,3375 MHz, RX: 418,3375 MHz
 PL TX: 210,7 Hz, PL RX: 210,7 Hz

STATOIL CH153 DSA CH 4
 TX: 459,4250 MHz, RX: 459,4250 MHz
 PL TX: 250,3 Hz, PL RX: 250,3 Hz

Notes:

DSA IS MOORED WITH 8 ANCHOR LINES 2 FROM EACH CORNER, PATTERN WILL BE E-MAILED ON REQUEST TO DSA-BRIDGE.

Cargo Connections:


Drillcutting / Waste: 4" Weco Male / Avery Hardoll
WBM: 4" Weco Male
Brine: 4" Weco Male
BaseOil: 4" Avery Hardoll
Diesel: 4" Avery Hardoll
Drill Water: 4" Weco Male
Pot Water: 4" Weco Male
Cement: 5" Weco Male
Barite: 5" Weco Female

BULK HANDLING / DRILLING LIQUID TRANSFER TO HANDLED THROUGH PUMP ROOM : CALL DERRICK MAN

BUNKER TRANSFER TO BE HANDLED THROUGH ENGINE CONTROL ROOM : CALL DSA ENGINE

NB:

NO BUNKER TRANSFER TO BE STARTED BEFORE BUNKERS DELIVERY NOTE IS RECEIVED ONBOARD IN HARD COPY/EMAIL

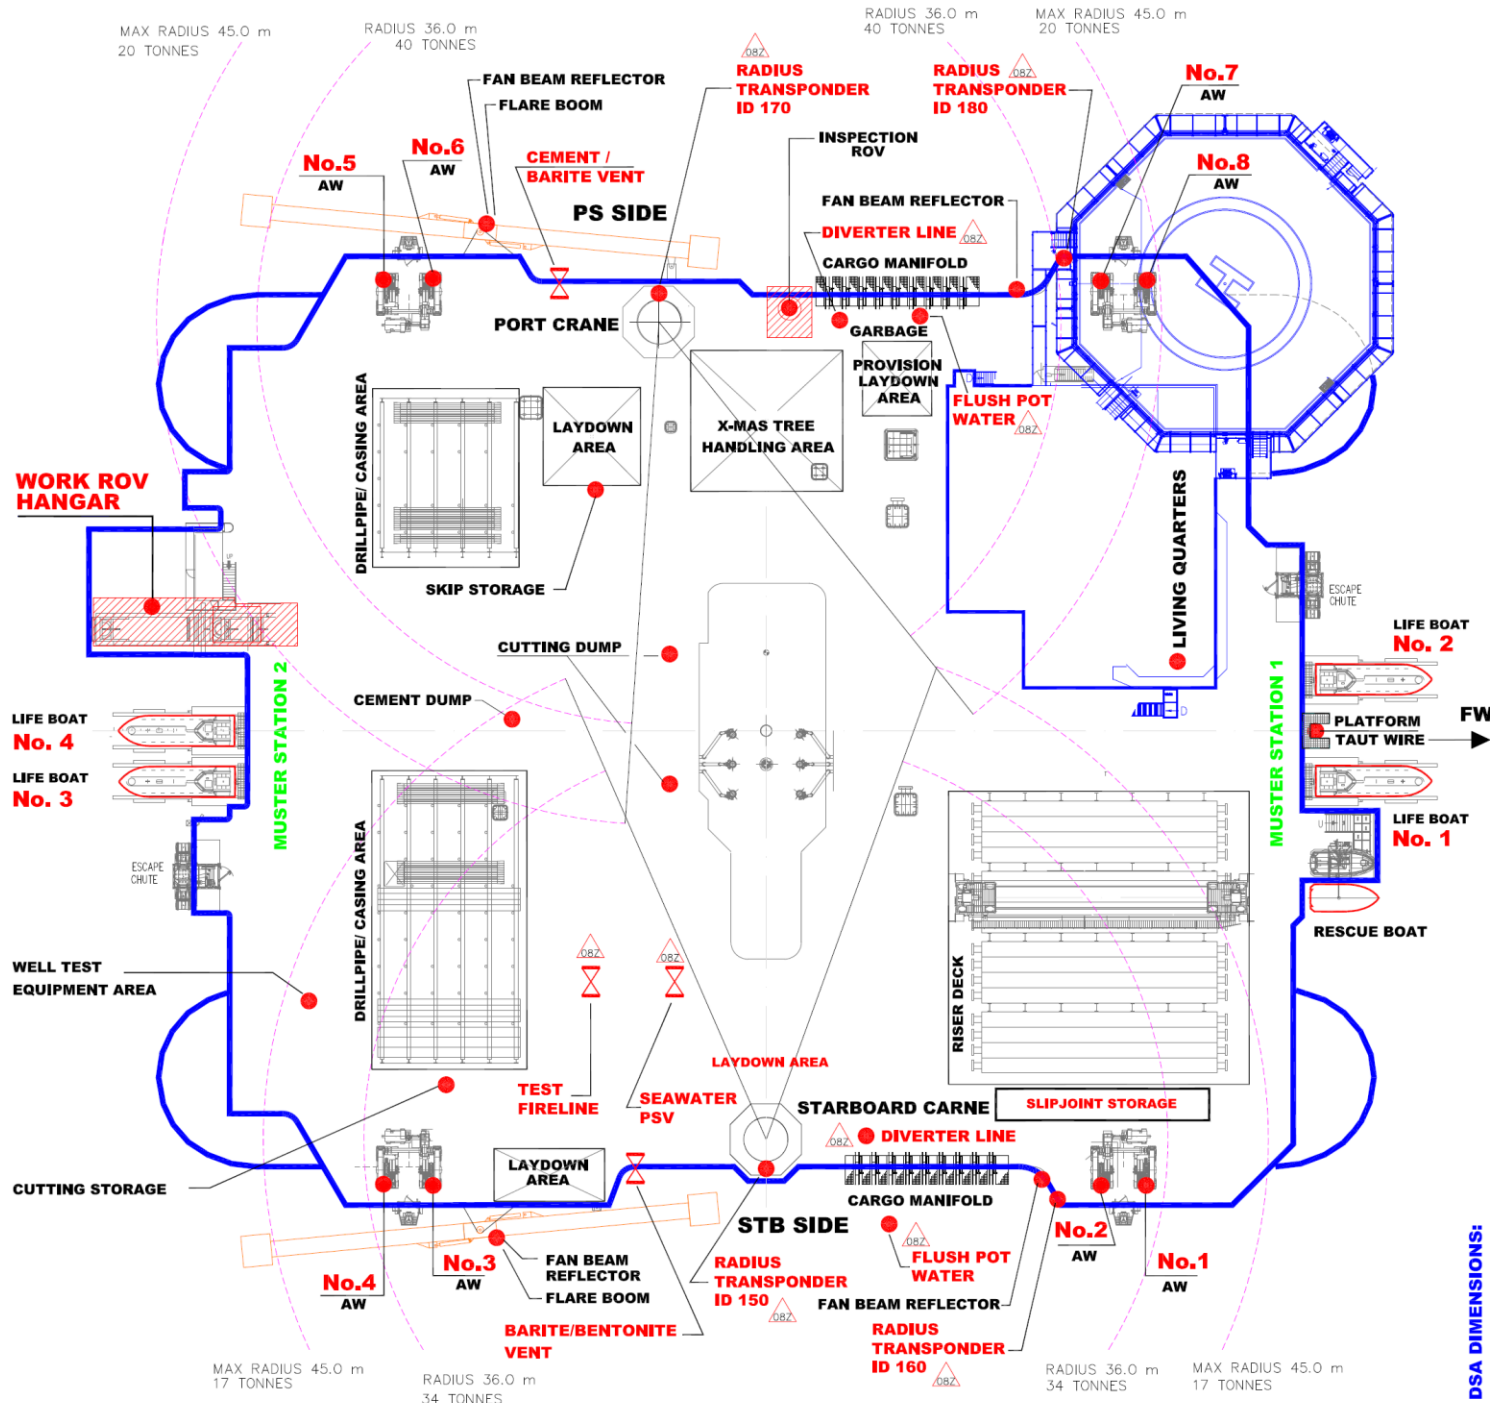

DSA DIMENSIONS:

LENGTH OVER ALL	ABT	118.60	m
BEAM OVER ALL	ABT	96.70	m
BEAM OUTSIDE PONTOONS		78.08	m
HEIGHT TO BOX BOTTOM		36.50	m
HEIGHT TO UPPER DECK		45.00	m
LENGTH OF PONTOONS		108.80	m
BEAM OF PONTOONS		16.00	m
HEIGHT OF PONTOONS		10.24	m
COLUMN LxB (CORNER RADIUS 3.20 m)		16.80x14.40	m
MAX OPERATION DRAUGHT		25.00	m
NORMAL OPERATION DRAUGHT		23.00	m
SURVIVAL DRAUGHT		19.00	m
TRANSIT DRAUGHT		9.94	m
AIR GAP AT STILL WATER (FROM 23.00 m)		13.50	m

LEGEND:
 = VENT

Docs: 621394

NO	DATE	REVISION/DESCRIPTION	DESIGN	CHECK	DATE	APP
08270314	As-built/MOD022879		JOMA	MMEN		TSL
07250812	As-built		JOMA	MMBA		EJE
06280403	Equipment info offshore					ELK
05230811	Offshore					
04220808	Revision by DP-Operator		non 21	DP-Operator		
03280806	AS-B / APPROVAL		non 21	DP-Operator		
02280805	REVISION		non 21	DP-Operator		
01280804	ISSUED FOR APPROVAL		non 21	DP-Operator		

Odofell Drilling AS
 Postboks 13
 0863 SESSON
 NORWAY

DEEPSEA ATLANTIC
 SEMI SUB DP-RIG Contact info: Supply Boat
 Navigating Deck & Upper Deck

DRAWING NUMBER: DSA-101-070-J-XE-0001

NO	REV	DATE	APPROVAL	DESIGN	CHECK	DATE	APP